



Chipsmall Limited consists of a professional team with an average of over 10 year of expertise in the distribution of electronic components. Based in Hongkong, we have already established firm and mutual-benefit business relationships with customers from,Europe,America and south Asia,supplying obsolete and hard-to-find components to meet their specific needs.

With the principle of "Quality Parts,Customers Priority,Honest Operation,and Considerate Service",our business mainly focus on the distribution of electronic components. Line cards we deal with include Microchip,ALPS,ROHM,Xilinx,Pulse,ON,Everlight and Freescale. Main products comprise IC,Modules,Potentiometer,IC Socket,Relay,Connector.Our parts cover such applications as commercial,industrial, and automotives areas.

We are looking forward to setting up business relationship with you and hope to provide you with the best service and solution. Let us make a better world for our industry!



## Contact us

Tel: +86-755-8981 8866 Fax: +86-755-8427 6832

Email & Skype: info@chipsmall.com Web: www.chipsmall.com

Address: A1208, Overseas Decoration Building, #122 Zhenhua RD., Futian, Shenzhen, China




DRAWING MADE IN AMERICAN PROJECTION

LOC 6 SHEET 14

© 1970 BY AMP INCORPORATED. ALL RIGHTS RESERVED. AMP PRODUCTS COVERED BY PATENTS AND/OR PATENTS PENDING.

REVISIONS			
LTR	DESCRIPTION	DATE	APPROVED
0	<del>REV PER G-5911</del>	7/1/88	<i>[Signature]</i>
E	REV PER G-5911	2/24/90	OKS/JS
C	331366 OBSOLETE G-2340	DAP 4/10/87	<i>[Signature]</i>

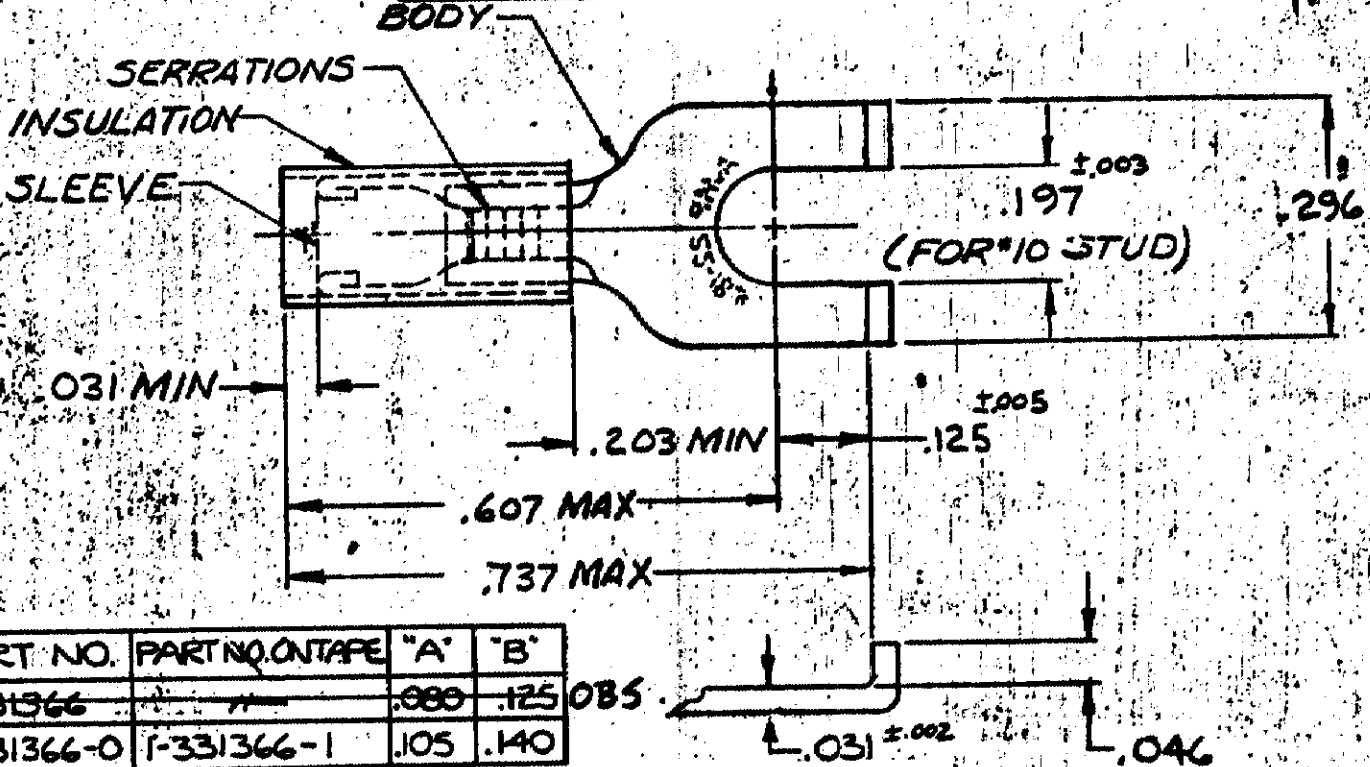

PART NO.	PART NO. ON TAPE	"A"	"B"
331366		.080	.125
1-331366-0	1-331366-1	.105	.140

FOR "A" TO "B" WIRE INS. DIA.  
 MARKING 22-18 FOR MILITARY  
 COMMERCIAL RANGE 22-16

1-331366-0 ON TAPE	1-331366-1	SLEEVE: COPPER (QQ-C-576)
WIRE	1-331366-0	BODY: COPPER (QQ-C-576)
Terminal	<del>331366</del> OBSOLETE	TIN PL (MIL-T-10727)
QTY	DESCRIPTION	INSULATION: NYLON
	PART NO	COLOR: RED
		MATERIAL & FINISH
UNLESS OTHERWISE SPECIFIED DIMENSIONS ARE IN INCHES. TOLERANCES ON: DECIMALS ±.008 ANGLES ±5°	CONTRACT NO.	AMP INCORPORATED HARRISBURG, PENNSYLVANIA
	DR. <i>[Signature]</i> 9-14-70	
	CHE. <i>[Signature]</i> 8-17-70	NAME WIRE TERMINAL
	APPD. <i>[Signature]</i> 8-17-70	P.I.D.G. - FLANGED SPADE
	REL. <i>[Signature]</i> 8-17-70	WIRE SIZE: 22-16
MATERIAL	DSGN APPD	SIZE A
SEE TABLE	OTHER APPD	CODE IDENT NO. 00779
		NUMBER 331366
		SCALE NTS
		SHEET 1 OF 1