



Chipsmall Limited consists of a professional team with an average of over 10 year of expertise in the distribution of electronic components. Based in Hongkong, we have already established firm and mutual-benefit business relationships with customers from,Europe,America and south Asia,supplying obsolete and hard-to-find components to meet their specific needs.

With the principle of “Quality Parts,Customers Priority,Honest Operation,and Considerate Service”,our business mainly focus on the distribution of electronic components. Line cards we deal with include Microchip,ALPS,ROHM,Xilinx,Pulse,ON,Everlight and Freescale. Main products comprise IC,Modules,Potentiometer,IC Socket,Relay,Connector.Our parts cover such applications as commercial,industrial, and automotives areas.

We are looking forward to setting up business relationship with you and hope to provide you with the best service and solution. Let us make a better world for our industry!



## Contact us

Tel: +86-755-8981 8866 Fax: +86-755-8427 6832



Email & Skype: info@chipsmall.com Web: www.chipsmall.com

Address: A1208, Overseas Decoration Building, #122 Zhenhua RD., Futian, Shenzhen, China




THIS DRAWING IS UNPUBLISHED. RELEASED FOR PUBLICATION 2000  
 © COPYRIGHT 2000 BY TYCO ELECTRONICS CORPORATION. ALL RIGHTS RESERVED.

LOC	DIST	REVISIONS			
P	LTR	DESCRIPTION	DATE	DWN	APVD
GW	-	A1	SR10-0146-01	09APR2001	CM KM
		A2	REV PER ECO-09-026495	01NOV09	KK AEG

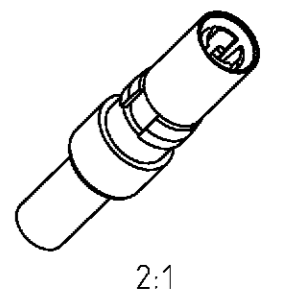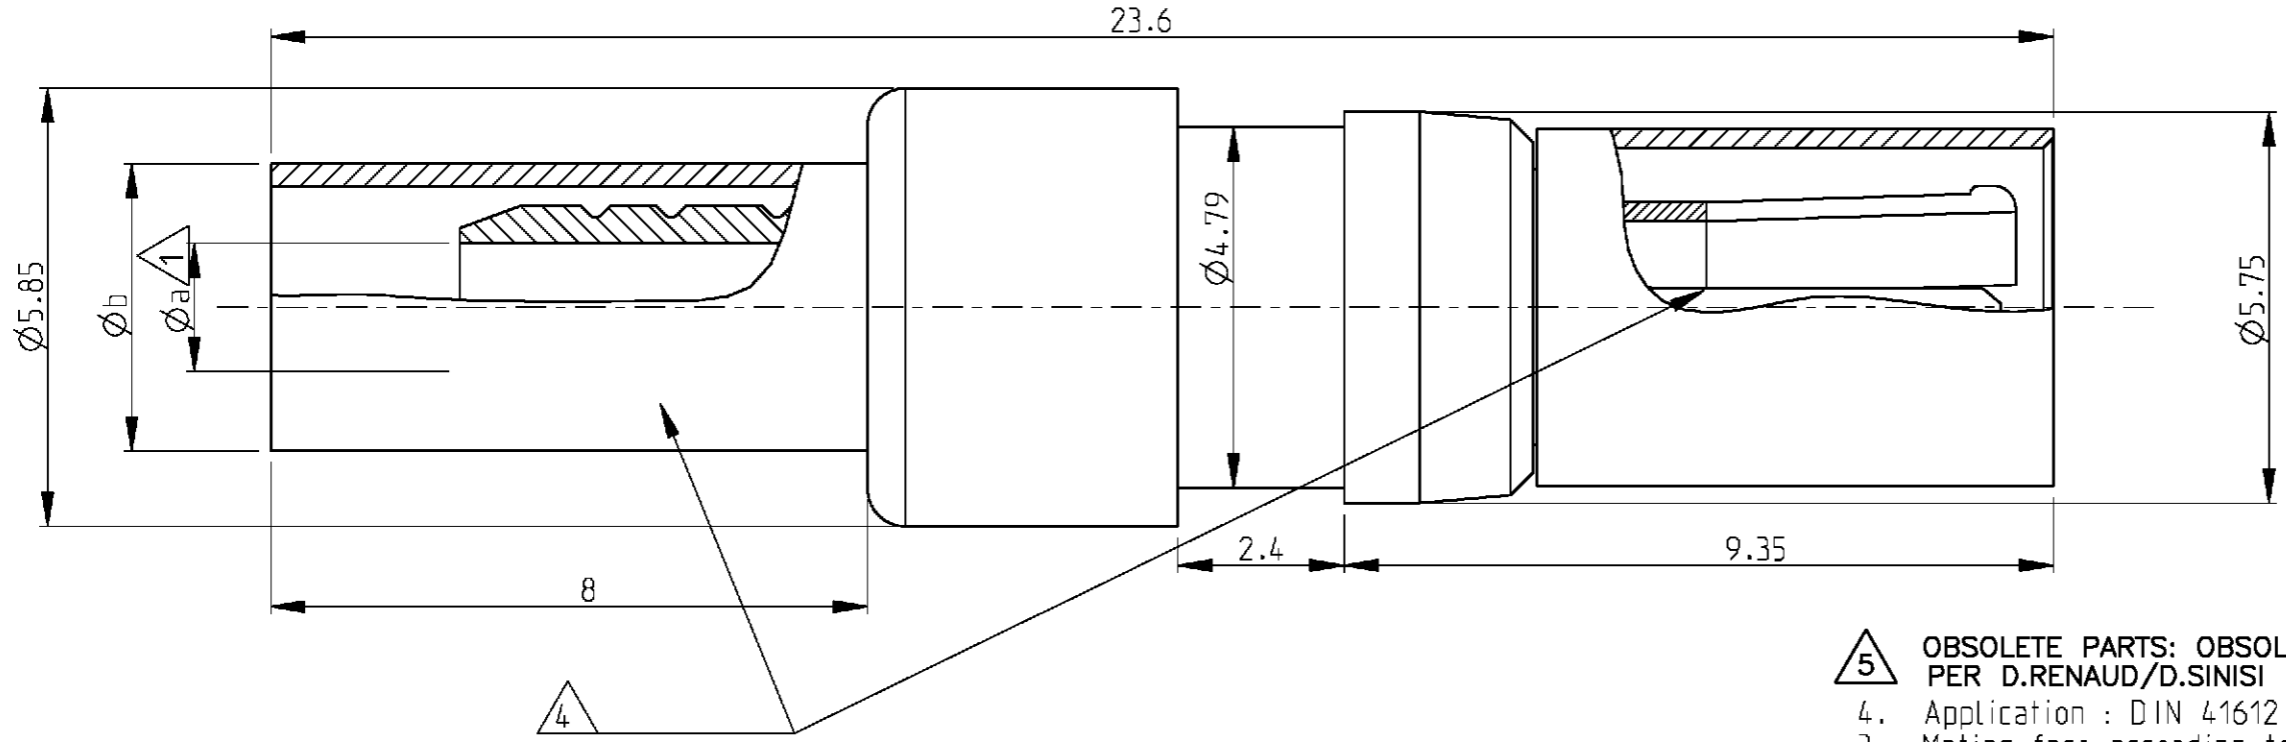

- 5 OBSOLETE PARTS: OBSOLETE CIS STREAMLINING PER D.RENAUD/D.SINISI
  - 4. Application : DIN 41612 Type M
  - 3. Mating face according to DIN 41626 Part 2
  - 2. Supplied as loose part
  - 1 Minimum dimension
- All dimensions are max dimensions unless otherwise specified

Old Nr	Tyco Nr	Cable Type	Dim a	Dim b	Description	Material	Plating
<del>5</del> OBSOLETE V23615-B302-E57A	<del>3-1393668-4</del>	RG179 B/U	1.7	3.85	Dielectric	PTFE	
					Outer Con.	Cu Be	1µm Au min in contact area
					Center Con.	Brass	1µm Au min in contact area
V23615-B302-E57	3-1393668-0	RG179 B/U	1.7	3.85	Dielectric	PTFE	
					Outer Con.	Cu Be	1µm Au min in contact area
					Center Con.	Brass	1µm Au min in contact area

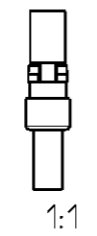

<small>THIS DRAWING IS A CONTROLLED DOCUMENT FOR TYCO ELECTRONICS CORPORATION. IT IS SUBJECT TO CHANGE AND THE CONTROLLING ENGINEERING ORGANIZATION SHOULD BE CONTACTED FOR THE LATEST REVISION.</small>		DWN MOROBE 03APR2001 CHK MATTHEEUS 9APR2001 APVD BOZZER 9APR2001	<b>tyco Electronics</b> Tyco Electronics Oostkamp - Belgium
DIMENSIONS: mm 	TOLERANCES UNLESS OTHERWISE SPECIFIED: 0 PLC ±0.5 1 PLC ±0.13 2 PLC ±0.013 3 PLC ±0.0001 4 PLC ANGLES ±	PRODUCT SPEC 108-71032 APPLICATION SPEC 114-71015 WEIGHT -	NAME CABLE PLUG 1.0/2.3 INSERT 75 Ohm SIZE A3 CAGE CODE 00779 DRAWING NO 3-1393668-0 RESTRICTED TO -
MATERIAL -	FINISH -		SCALE 10/1 SHEET 1 OF 1 REV A2