



Chipsmall Limited consists of a professional team with an average of over 10 year of expertise in the distribution of electronic components. Based in Hongkong, we have already established firm and mutual-benefit business relationships with customers from,Europe,America and south Asia,supplying obsolete and hard-to-find components to meet their specific needs.

With the principle of "Quality Parts,Customers Priority,Honest Operation,and Considerate Service",our business mainly focus on the distribution of electronic components. Line cards we deal with include Microchip,ALPS,ROHM,Xilinx,Pulse,ON,Everlight and Freescale. Main products comprise IC,Modules,Potentiometer,IC Socket,Relay,Connector.Our parts cover such applications as commercial,industrial, and automotives areas.

We are looking forward to setting up business relationship with you and hope to provide you with the best service and solution. Let us make a better world for our industry!



Contact us

Tel: +86-755-8981 8866 Fax: +86-755-8427 6832


Email & Skype: info@chipsmall.com Web: www.chipsmall.com

Address: A1208, Overseas Decoration Building, #122 Zhenhua RD., Futian, Shenzhen, China



MADE IN AMERICA PROJECTION
 BY AMP INCORPORATED, ALL RIGHTS RESERVED
 UNPUBLISHED COPYRIGHT
 REPRODUCED OR TRANSMITTED IN ANY FORM OR BY ANY MEANS WITHOUT WRITTEN PERMISSION OF AMP INCORPORATED.

REVISIONS			
LTR	DESCRIPTION	DATE	APPROVED
O	NPS 74-0337	PM 6-4-74	<i>JM</i>
A	REVISED ECN P-7424	PM 12/20/74	L.D.
B	INACT P9268	12-13-82	<i>JM</i>
C	OBS -4 REV G 2589	BT 10-12-87	<i>JM</i>

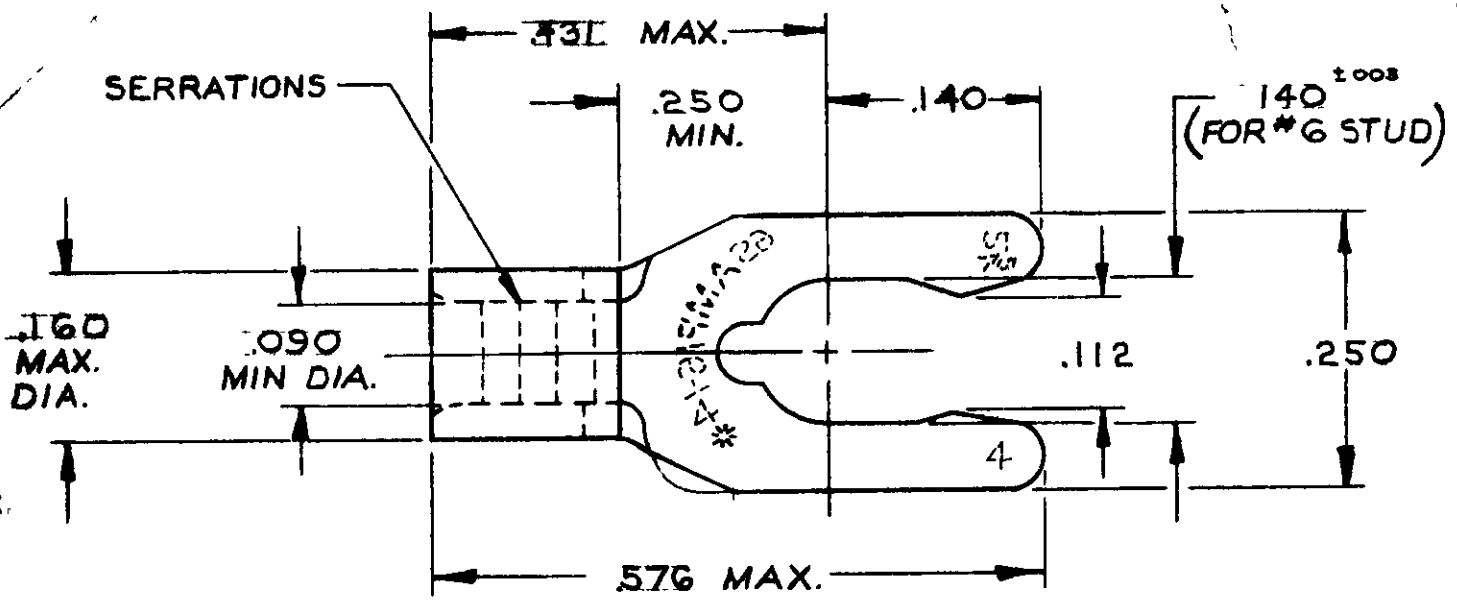

INACTIVE
 P9268
 JM
 12-13-82

~~ENGINEERING CONTROLLED~~

OBSOLETE ~~53010-4~~ 53010-3

PART NO ON TAPE PART NO

UNLESS OTHERWISE SPECIFIED DIMENSIONS ARE IN INCHES
 TOLERANCES ON:
 DECIMALS ±.008
 FRACTIONS ±.005

CONTRACT NO.	H
DR.	Phil Monaghan 5-30-74
CHK	JM 6-4-74
APPD	Les Abel 6-5-74
REL	Phil Monaghan 8-5-74
DSGN APPD	JL Brown 6-4-74
OTHER APPD	



AMP INCORPORATED
 HARRISBURG, PENNSYLVANIA

NAME
 WIRE TERMINAL BUDGET - SPRING SPADE (SHORT)
 WIRE SIZE: 16-14

MATERIAL
 PHOSPHOR BRONZE
 (MIL-C-576)
 TIN PLATED
 (MIL-T-1072)

SIZE	CODE IDENT NO.	NUMBER
A	00779	53010

SCALE NTS SHEET 1 OF 1