

Chipsmall Limited consists of a professional team with an average of over 10 year of expertise in the distribution of electronic components. Based in Hongkong, we have already established firm and mutual-benefit business relationships with customers from, Europe, America and south Asia, supplying obsolete and hard-to-find components to meet their specific needs.

With the principle of "Quality Parts, Customers Priority, Honest Operation, and Considerate Service", our business mainly focus on the distribution of electronic components. Line cards we deal with include Microchip, ALPS, ROHM, Xilinx, Pulse, ON, Everlight and Freescale. Main products comprise IC, Modules, Potentiometer, IC Socket, Relay, Connector. Our parts cover such applications as commercial, industrial, and automotives areas.

We are looking forward to setting up business relationship with you and hope to provide you with the best service and solution. Let us make a better world for our industry!



## Contact us

Tel: +86-755-8981 8866 Fax: +86-755-8427 6832

Email & Skype: info@chipsmall.com Web: www.chipsmall.com

Address: A1208, Overseas Decoration Building, #122 Zhenhua RD., Futian, Shenzhen, China







4


RELEASED FOR PUBLICA


PYRIGHT - BY TYCO ELECTRONICS CORPORATION.

ALL RIGHTS RESERVED

A/F C

TD

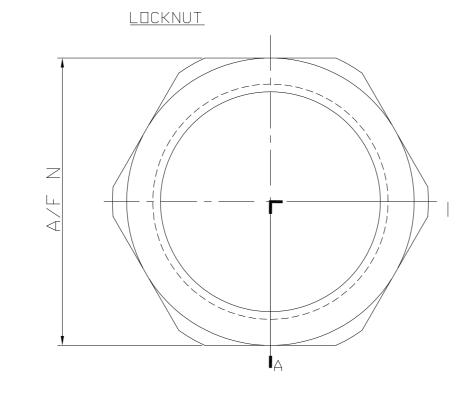

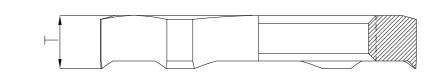

SECTION A-A

SIZE	TD mm	TL mm	T mm	Min. Shield Diameter mm	A/F BODY	A/F CAP	A/F NUT	-	g Range nm
PG 7	13.0	10.0	3.3	2.5	14	14	15	3.0	6.5
PG 9	16.0	10.0	3.3	3.0	17	17	18	4.0	8.0
PG 11	19.0	10.0	3.5	4.0	20	20	21	5.0	10.0
PG 13,5	21.0	10.0	3.5	5.0	22	22	23	6.0	12.0
PG 16	23.0	10.0	3.5	8.0	24	24	26	10.0	14.0
PG 21	29.0	12.0	4.0	11.0	30	30	32	13.0	18.0
PG 29	37.0	12.0	4.6	16.0	40	40	41	18.0	25.0
PG 36	47.0	14.0	5.6	19.0	50	50	51	22.0	32.0
PG 42	54.0	16.0	5.6	27.0	58	58	60	30.0	38.0
PG 48	59.0	18.0	6.1	30.0	64	64	64	34.0	44.0

/ 3	

Part No.	Packing Label Description	Packing Label Description Line	Packing Label Descripotion	Packing Label Descripotion	
Fait No.	Line 1	2	Line 3	Line 4	
1478885-1	EMC Gland with Locknut	PG7 (Long Thread 10mm)	Brass Nickel Plated	IP 68	
1478885-2	EMC Gland with Locknut	PG9 (Long Thread 10mm)	Brass Nickel Plated	IP 68	
1478885-3	EMC Gland with Locknut	PG11 (Long Thread 10mm)	Brass Nickel Plated	IP 68	
1478885-4	EMC Gland with Locknut	PG13.5 (Long Thread 10mm)	Brass Nickel Plated	IP 68	
1478885-5	EMC Gland with Locknut	PG16 (Long Thread 10mm)	Brass Nickel Plated	IP 68	]
1478885-6	EMC Gland with Locknut	PG21 (Long Thread 12mm)	Brass Nickel Plated	IP 68	
<del>1478885-7</del>	EMC Gland with Locknut	PG29 (Long Thread 12mm)	Brass Nickel Plated	IP 68	OBSOL
1478885-8	EMC Gland with Locknut	PG36 (Long Thread 14mm)	Brass Nickel Plated	IP 68	
<del>-1478885-9</del>	EMC Gland with Locknut	PG42 (Long Thread 16mm)	Brass Nickel Plated	IP 68	OBSO
<del>1-1478885-0</del>	EMC Gland with Locknut	PG48 (Long Thread 18mm)	Brass Nickel Plated	IP 68	0030

NOTES

- 1 FOR TECHNICAL DATA REFER TO YOUR LOCAL TYCO ELECTRONICS SALES OFFICE.
- 2 ALL DIMENSIONS ARE NOMINAL FOR REFERENCE ONLY UNLESS OTHERWISE STATED.



FOR PACKAGING INFORMATION SEE PACKING SPECIFICATION 107-3315 TABLE ABOVE SHOWS PACKING LABEL DETAILS.

4 1 ASSEMBLY COMPRISES OF 1 OFF GLAND & CAP (AS SHOWN) INCLUDING NEOPRENE SEAL.

PG EMC Gland PG48 Nickel Plate 1-1478885-0 OBSOLETE PG EMC Gland PG42 Nickel Plate <del>1478885-9</del> PG EMC Gland PG36 Nickel Plate 1478885-8 OBSOLETE PG EMC Gland PG29 <del>1478885-7</del> Nickel Plate Bag with TE PG EMC Gland PG21 1478885-6 Label & Nickel Plate Instruction PG EMC Gland PG16 Nickel Plate 1478885-5 Sheet PG EMC Gland PG13.5 Nickel Plate 1478885-4 5 2 PG EMC Gland PG11 Nickel Plate 1478885-3 5 PG EMC Gland PG9 5 Nickel Plate 1478885-2 PG EMC Gland PG7 5 Nickel Plate 1478885-1 Packaging Bag Qty Description Finish Part No. Style ₹ Tyco Tyco Electronics Corporation

THIS DRAWING IS A CONTROLLED DOCUMENT. 6-11-02 Électronics Stanmore, Middlesex, HA7 4RS F.W.King DIMENSIONS: 6-11-02 MM EMC GLAND AND LOCKNUT PRODUCT SPEC BRASS - NICKEL PLATE (PG7 - PG48) APPLICATION SPEC SIZE CAGE CODE DRAWING NO A2 | 00779 **C-** 1478885 MATERIAL WEIGHT CUSTOMER DRAWING