Chipsmall Limited consists of a professional team with an average of over 10 year of expertise in the distribution of electronic components. Based in Hongkong, we have already established firm and mutual-benefit business relationships with customers from,Europe,America and south Asia,supplying obsolete and hard-to-find components to meet their specific needs.

With the principle of “Quality Parts,Customers Priority,Honest Operation,and Considerate Service”,our business mainly focus on the distribution of electronic components. Line cards we deal with include Microchip,ALPS,ROHM,Xilinx,Pulse,ON,Everlight and Freescale. Main products comprise IC,Modules,Potentiometer,IC Socket,Relay,Connector.Our parts cover such applications as commercial,industrial, and automotives areas.

We are looking forward to setting up business relationship with you and hope to provide you with the best service and solution. Let us make a better world for our industry!

Contact us

Tel: +86-755-8981 8866 Fax: +86-755-8427 6832
Email & Skype: info@chipsmall.com Web: www.chipsmall.com
Address: A1208, Overseas Decoration Building, #122 Zhenhua RD., Futian, Shenzhen, China

DO NOT SCALE PRINT

REV.

DWG. NO. 1-1437507-0

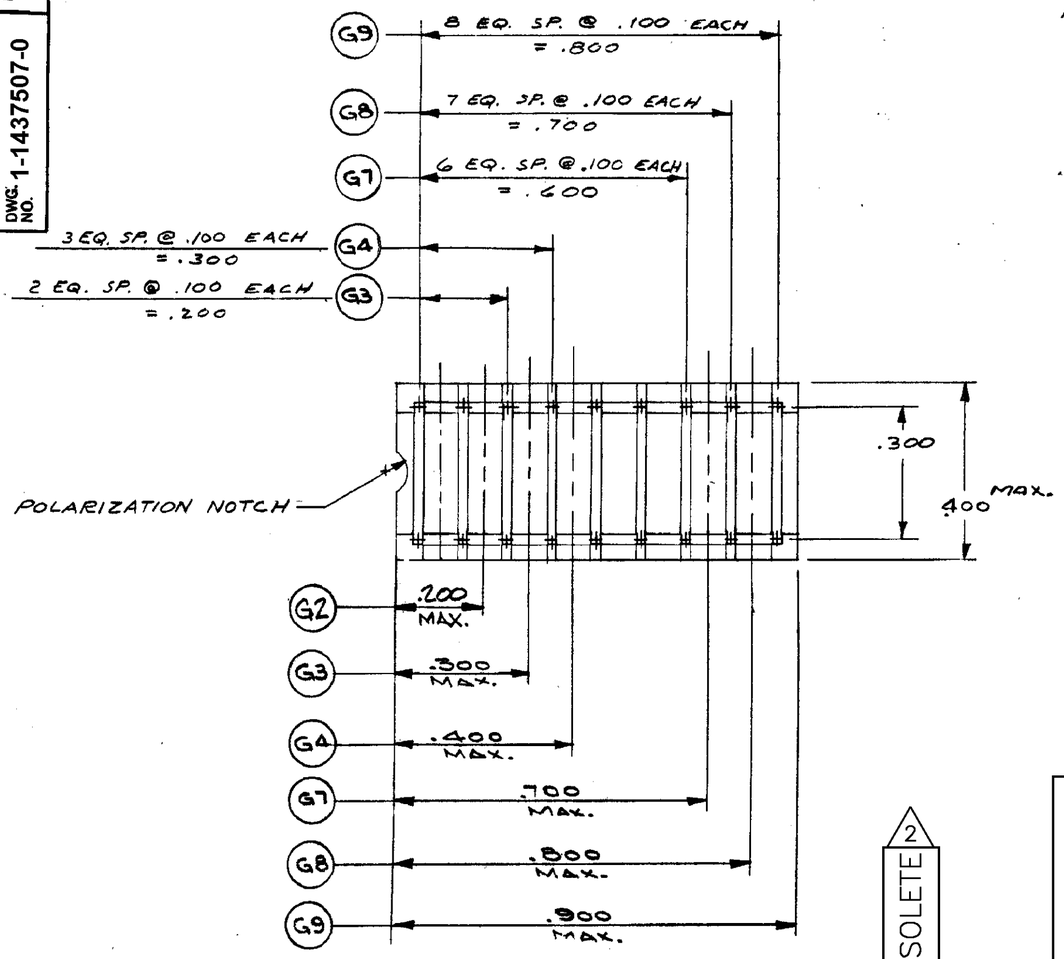

NOTES:

1. MATERIAL AND FINISH:
   INSULATOR —— THERMOPLASTIC POLYESTER UL RATED 94V-0; COLOR-BLACK
   (G) CONTACT —— PHOSPHOR BRONZE, GOLD OVER NICKEL PLATE
   (GT) CONTACT —— PHOSPHOR BRONZE, TIN PLATE.

2 OBSOLETE PARTS: OBSOLETE CIS STREAMLINING PER D.RENAUD/D.SINISI

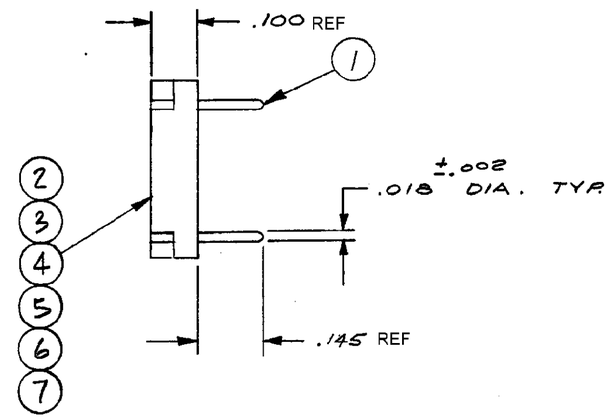

G25	G24	G23	G2T	G9T	G8T	G7T	G4T	G3T	G2	G9	G8	G7	G4	G3	DESCRIPTION	ITEM NO.
N/A	~~1-1437507-2~~ OBSOLETE 2	1-1437507-1	N/A	~~2-1437507-2~~ SUP BY 2-1437507-1	2-1437507-0	~~1-1437507-8~~ OBSOLETE 2	1-1437507-6	~~1-1437507-4~~ OBSOLETE	1-1437507-0	2-1437507-1	1-1437507-9	1-1437507-7	1-1437507-5	1-1437507-3	PART NO.S	—
9	8	7													SHORTING PIN	1
			2	9	8	7	4	3							SHORTING PIN	1
			1						1						INSULATOR	7
1				1						1					INSULATOR	6
	1				1						1				INSULATOR	5
		1				1						1			INSULATOR	4
							1						1		INSULATOR	3
								1						1	INSULATOR	2
									2	9	8	7	4	3	SHORTING PIN	1
QUANTITY									QUANTITY							

UNLESS OTHERWISE SPECIFIED DIMENSIONS ARE IN INCHES
TOLERANCES ON
FRACTIONS DECIMALS ANGLES
REF

MATERIAL: —

FINISH: —

LTR	変更 (REVISION RECORD)	DR	CHK	DATE
A1	REVISED PER ECO-11-005140	RK	HMR	31MAR11

ORIGINAL DATE OF DRAWING: 4-4-73
DRAWN: RJS DATE: 4-4-74
CHECKED: R.J.H. DATE: 4-5-74
APPROVED: R.J.H. DATE: 4-5-74
CODE IDENT. NO. 91506 DWG. SIZE C
NEXT ASSY.

TE Connectivity

TITLE: PROGRAMMING PLUG

DWG. NO. 1-1437507-0 REV. A1

SCALE: 4X1 SHEET 1 OF 1

CUSTOMER DWG.